# ST. TAMMANY PARISH COUNCIL

# ORDINANCE

ORDINANCE CALENI	DAR NO.	3422	ORDINANCE (	COUNCIL SERI	ES NO.
COUNCIL SPONSOR	STEFA	NCIK/DAVIS	PROVIDED B	SY: PLANNING	G
INTRODUCED BY: _	MR. BUI	RKHALTER	SECONDED B	Y: MR. HAM	AUEI
ON THE 2 <sup>ND</sup> I	DAY OF _	NOVEMBER	, 2006		
La, to rec 59, north and whice from its Ward 4,	classify a control of Grande h property present A-District 5	ertain parcel le Maison Boul comprises a to 3 (Suburban) I (ZC06-08-07)		ide of LA Highw 22, De Val Estato of land more or le itutional) Distric	vay es ess,
law, Case No. <u>ZC06-08</u> that the zoning classific District to a ID (Institut	<u>8-070,</u> has a <del>tion of</del> th	recommend <u>ed</u> e <del>above refere</del>	nced area be change	ne Parish of St. T ed from its preser	ammany, Louisiana
Whereas, the St.	Tamman	y Parish Counc	il has held its publi	c hearing in acco	ordance with law:
Whereas, the St the public health, safety (Institutional) District.			cil has found it nece designate the above	- , ,	
THE PARISH (	OF ST. TA	MMANY HEI	REBY ORDAINS, i	n regular sessior	n convened that:
SECTION I: The its present A-3 (Suburb			of the above describe tutional) District.	ed property is her	reby changed from
SECTION II: T amended to incorporate			f the Parish of St. T on specified in Sect	_	and is hereby
REPEAL: All C	Ordinances	s or parts of Or	dinances in conflict	herewith are her	reby repealed.
SEVERABILIT shall not affect other pr this end the provisions	ovisions h	erein which ca		ithout the invalid	
EFFECTIVE D	ATE: This	Ordinance sh	all become effective	fifteen (15) day	s after adoption.
MOVED FOR ADOPT	TON BY:		SECONDEI	) BY:	
WHEREUPON THE FOLLOWING:	THIS OR	DINANCE W	AS SUBMITTED T	O A VOTE AN	D RESULTED IN
YEAS:					
NAYS:	•				
ABSTAIN:					
ABSENT:					

TWO CERTAIN LOTS OR PORTIONS OF GROUND, together with all the buildings and improvements thereon, and all of the rights. ways, privilege, servitudes, advantages, prescriptions and appurtenances thereunto belonging or in anywise appertaining, situated and located in Section 25, Township 7 South, Range 12 East and in the subdivision known as "DE VAL ESTATES SITES", and designated as Lots 20 and 21, of said subdivision, which said lots adjoin each and measures as follows: Lot No. 20, measures One Hundred (100) feet front on State Highway No. 59 (Mandeville-Abita Springs Highway), the same width in the rear, by a depth on its side line common to Lot 19 of 293.9 feet and a depth on its other side line of 301.05 feet. Lot No. 21, measures One Hundred (100) feet front on State Highway No. 59, same width in rear, by a depth on its side line common to Lot 20 of 301.05 feet and a depth on its other side line common on Lot 22 of 309.1 feet. All in accordance with a plan and certificate of survey made by E. J. Champagne, Surveyor, on November 15, 1957, on file in the office of the Clerk of Court for the Parish of St. Tammany.

ALL THAT CERTAIN LOT OR PARCEL OF GROUND, together with all the buildings and improvements thereon, and all the rights, ways, means, privileges, servitudes, prescriptions, appurtenances and advantages thereunto belonging or in anywise appertaining, being situated in the State of Louisiana, Parish of St. Tammany, in that part thereof known as DeVal Estates Sites Subdivision, in accordance with the plan of subdivision filed with the Clerk of Court for St. Tammany Parish, Louisiana in Map File #146-A, and being more fully described as follows, to-wit:

LOT 22, DEVAL ESTATES SITES SUBDIVISION, ST. TAMMANY PARISH, LOUISIANA.

Being the same property acquired by Cornerstone Assembly of God from Weldon P. Smith and Caroline Post Smith by act dated February 13, 1994 (sic) and recorded as Instrument No. 938794 of the records of St. Tammany Parish, Louisiana.

3422

**CASE NO.:** 

ZC06-08-070

PETITIONER:

Clave Gill & Deborah Hopkins

**OWNER:** 

RBF, L.L.C.

REQUESTED CHANGE: From A-3 (Suburban) District to ID (Institutional) District

LOCATION:


Parcel located on the east side of LA Highway 59, north of Grande


Maison Blvd., Lots 20, 21, 22, De Val Estates; S25, T7S, R12E; Ward

4, District 5

SIZE:

2,088 acres

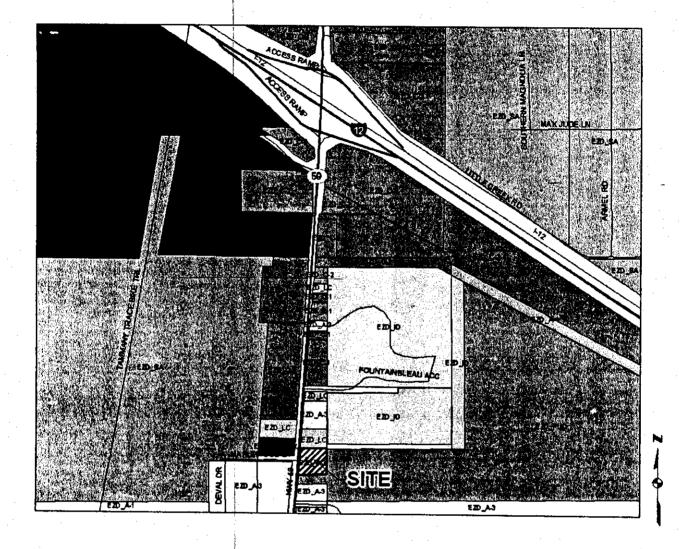

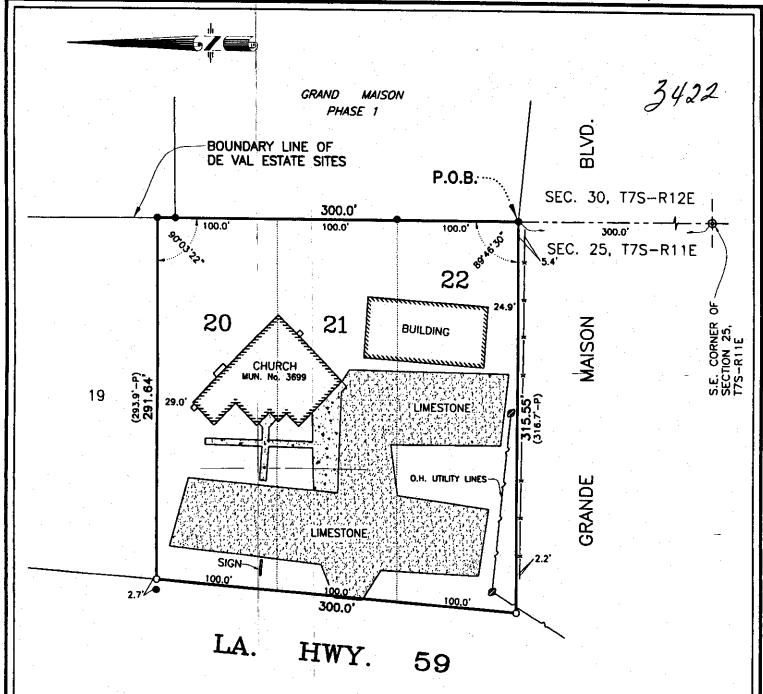

TOTAL AREA WITHIN PERIMETER = 2.088 ACRES

### <u>LEGEND</u>

• = IRON ROD FOUND
O = IRON ROD SET
Ø = UTILITY POLE
P = PER SUBD. PLAN

REFERENCE SURVEY:
PLAT OF BY CARY E. SMITH LAND SURVEYS, INC., DATED 5-27-92, DRAWING No. 92-186.

## NOTE:

ANY UTILITIES, DITCHES, AND/OR SERVITUDES THAT MAY EXIST WITHIN THIS PROPERTY, IF ANY, ARE NOT SHOWN HEREON.

THIS IS TO CERTIFY THAT I HAVE CONSULTED THE F.E.M.A. FLOOD INSURANCE RATE MAPS AND FIND THAT THE SUBJECT PROPERTY IS LOCATED IN FLOOD ZONE "C" PER PANEL NUMBER 225205 0245 C, DATED 10-17-89.

THIS IS TO CERTIFY THAT THIS PLAT REPRESENTS AN ACTUAL SURVEY MADE ON THE GROUND UNDER THE DIRECT SUPERVISION OF THE UNDERSIGNED AND IS IN ACCORDANCE WITH THE ADOPTED LOUISIANA MINIMUM STANDARDS OF PRACTICE FOR PROPERTY BOUNDARY SURVEYS FOR A CLASS "C" SURVEY.


SURVEY OF LOTS 20, 21, & 22
DE VAL ESTATE SITES
SITUATED IN SECTION 25
TOWNSHIP 7 SOUTH RANGE 11 EAST ST. TAMMANY PARISH, LA

PREPARED FOR:

RBF, L.L.C.

80

=

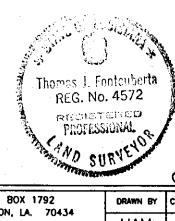

**TJF** 

**HAM** 

**FONTCUBERTA** INCORPORATED

> **PROFESSIONAL** LAND SURVEYORS

463943

130 - 119

SURVEYOR P.O. BOX 1792 JOB NO. DATE SCALE DRAWN BY CHECKED BY PLAT FILE NO. COVINGTON, LA. 70434 -24-2006

PHONE: (985) 893-7461